


Notes: 1. Do not Scale
 2. Check all dimensions on site
 3. © Pace Jefford Moore Architects llp

KEY

600 x 600 mm Titan RMG on Titan RMF corner lock pedestals, centered from grid line A2

Note: New Fire Barriers (30 min) to be positioned in locations indicated on the drawing

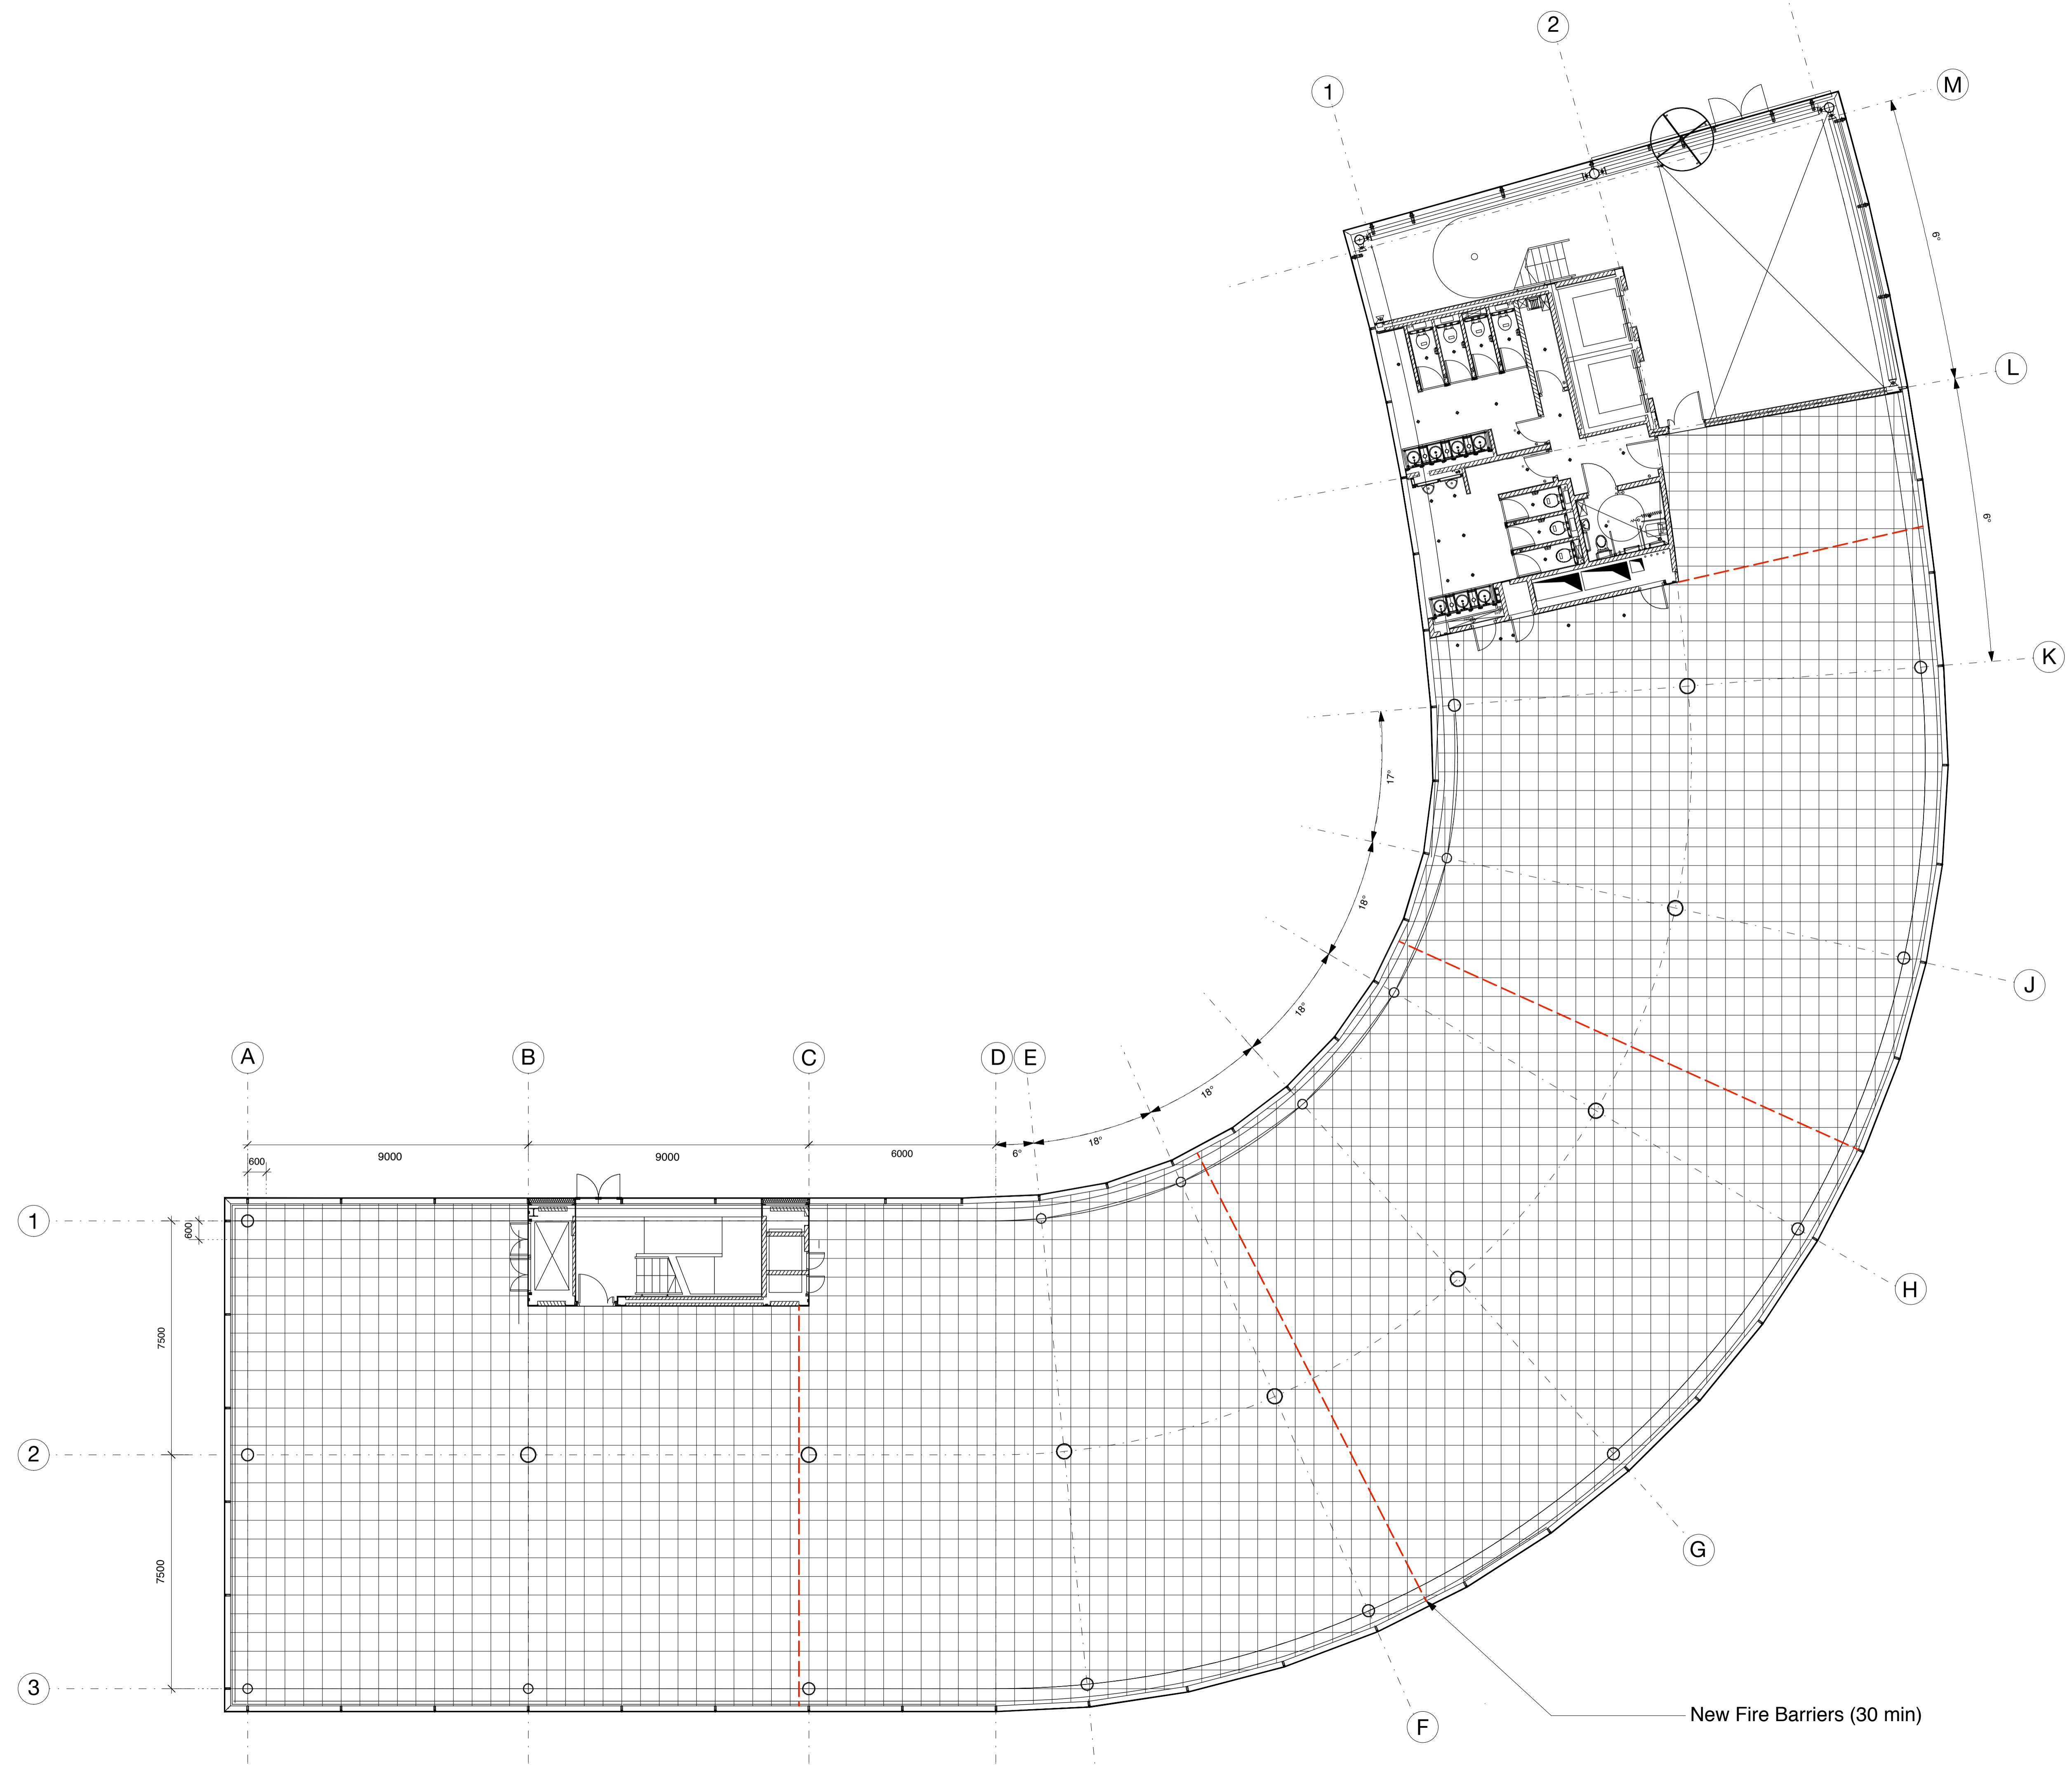

Record Drawing

No	Date	By	Revision

Project
Building 2, Aviator Park,
 Addlestone, KT15 2PG

Drawing
 Raised Access Floor Plan, Ground Floor

Job	Dwg No.	Date Drawn
1386	310	10.02.16

Scale	Drawing Print Format
1:100@A1	A1
By	Checked
SB	GP

PJMA
 PACE | JEFFORD | MOORE ARCHITECTS LLP
 16 Hampden Gurney Street, London W1H 5AL
 T 020 7724 7343 E info@pjma.eu W pjma.eu

RIBA 
 Chartered Practice