


Notes: 1. Do not Scale  
 2. Check all dimensions on site  
 3. © Pace Jefford Moore Architects llp

KEY

600 x 600 mm Titan RMG on Titan RMF corner lock pedestals, centered from grid line A2

Note: New Fire Barriers (30 min) to be positioned in locations indicated on the drawing

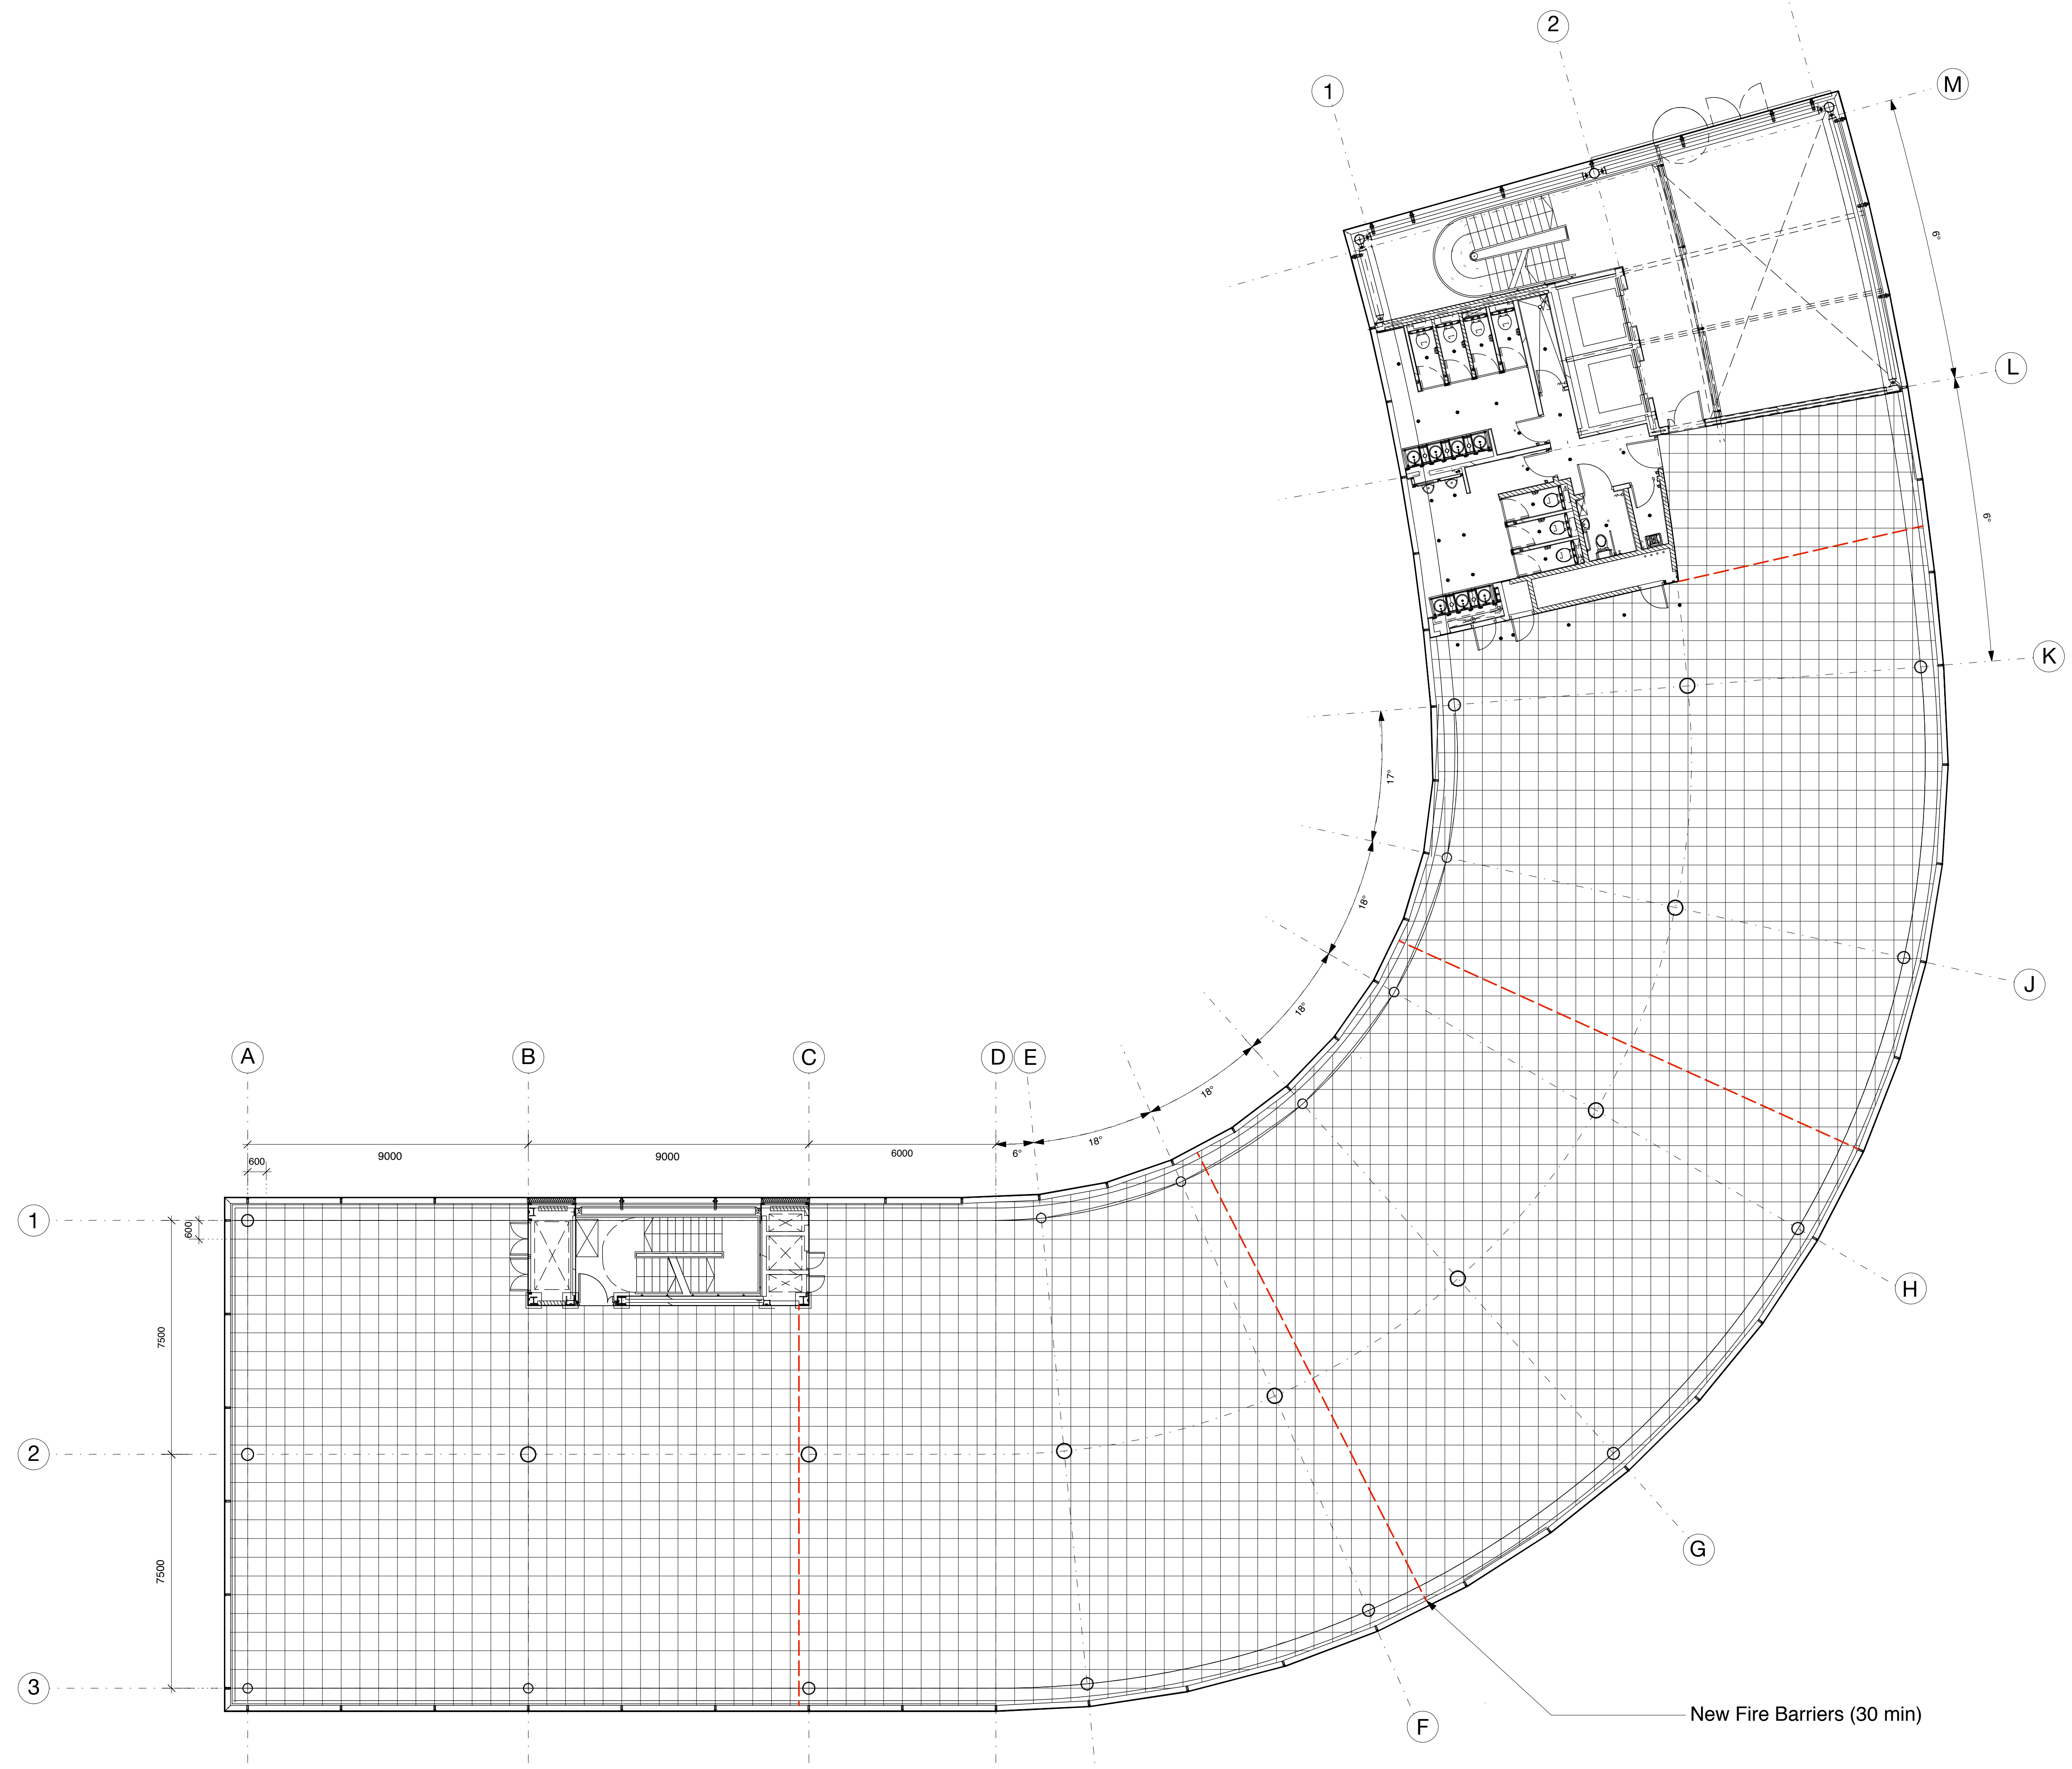

Record Drawing

No	Date	By	Revision

Project  
**Building 2, Aviator Park,**  
 Addlestone, KT15 2PG

Drawing  
 Raised Access Floor Plan, First Floor

Job	Dwg No.	Date Drawn
1386	311	10.02.16

Scale	Drawing Print Format
1:100@A1	A1
By	Checked
SB	GP

**PJMA**  
 PACE | JEFFORD | MOORE ARCHITECTS LLP  
 16 Hampden Gurney Street, London W1H 5AL  
 T 020 7724 7343 E info@pjma.eu W pjma.eu

**RIBA**   
 Chartered Practice