
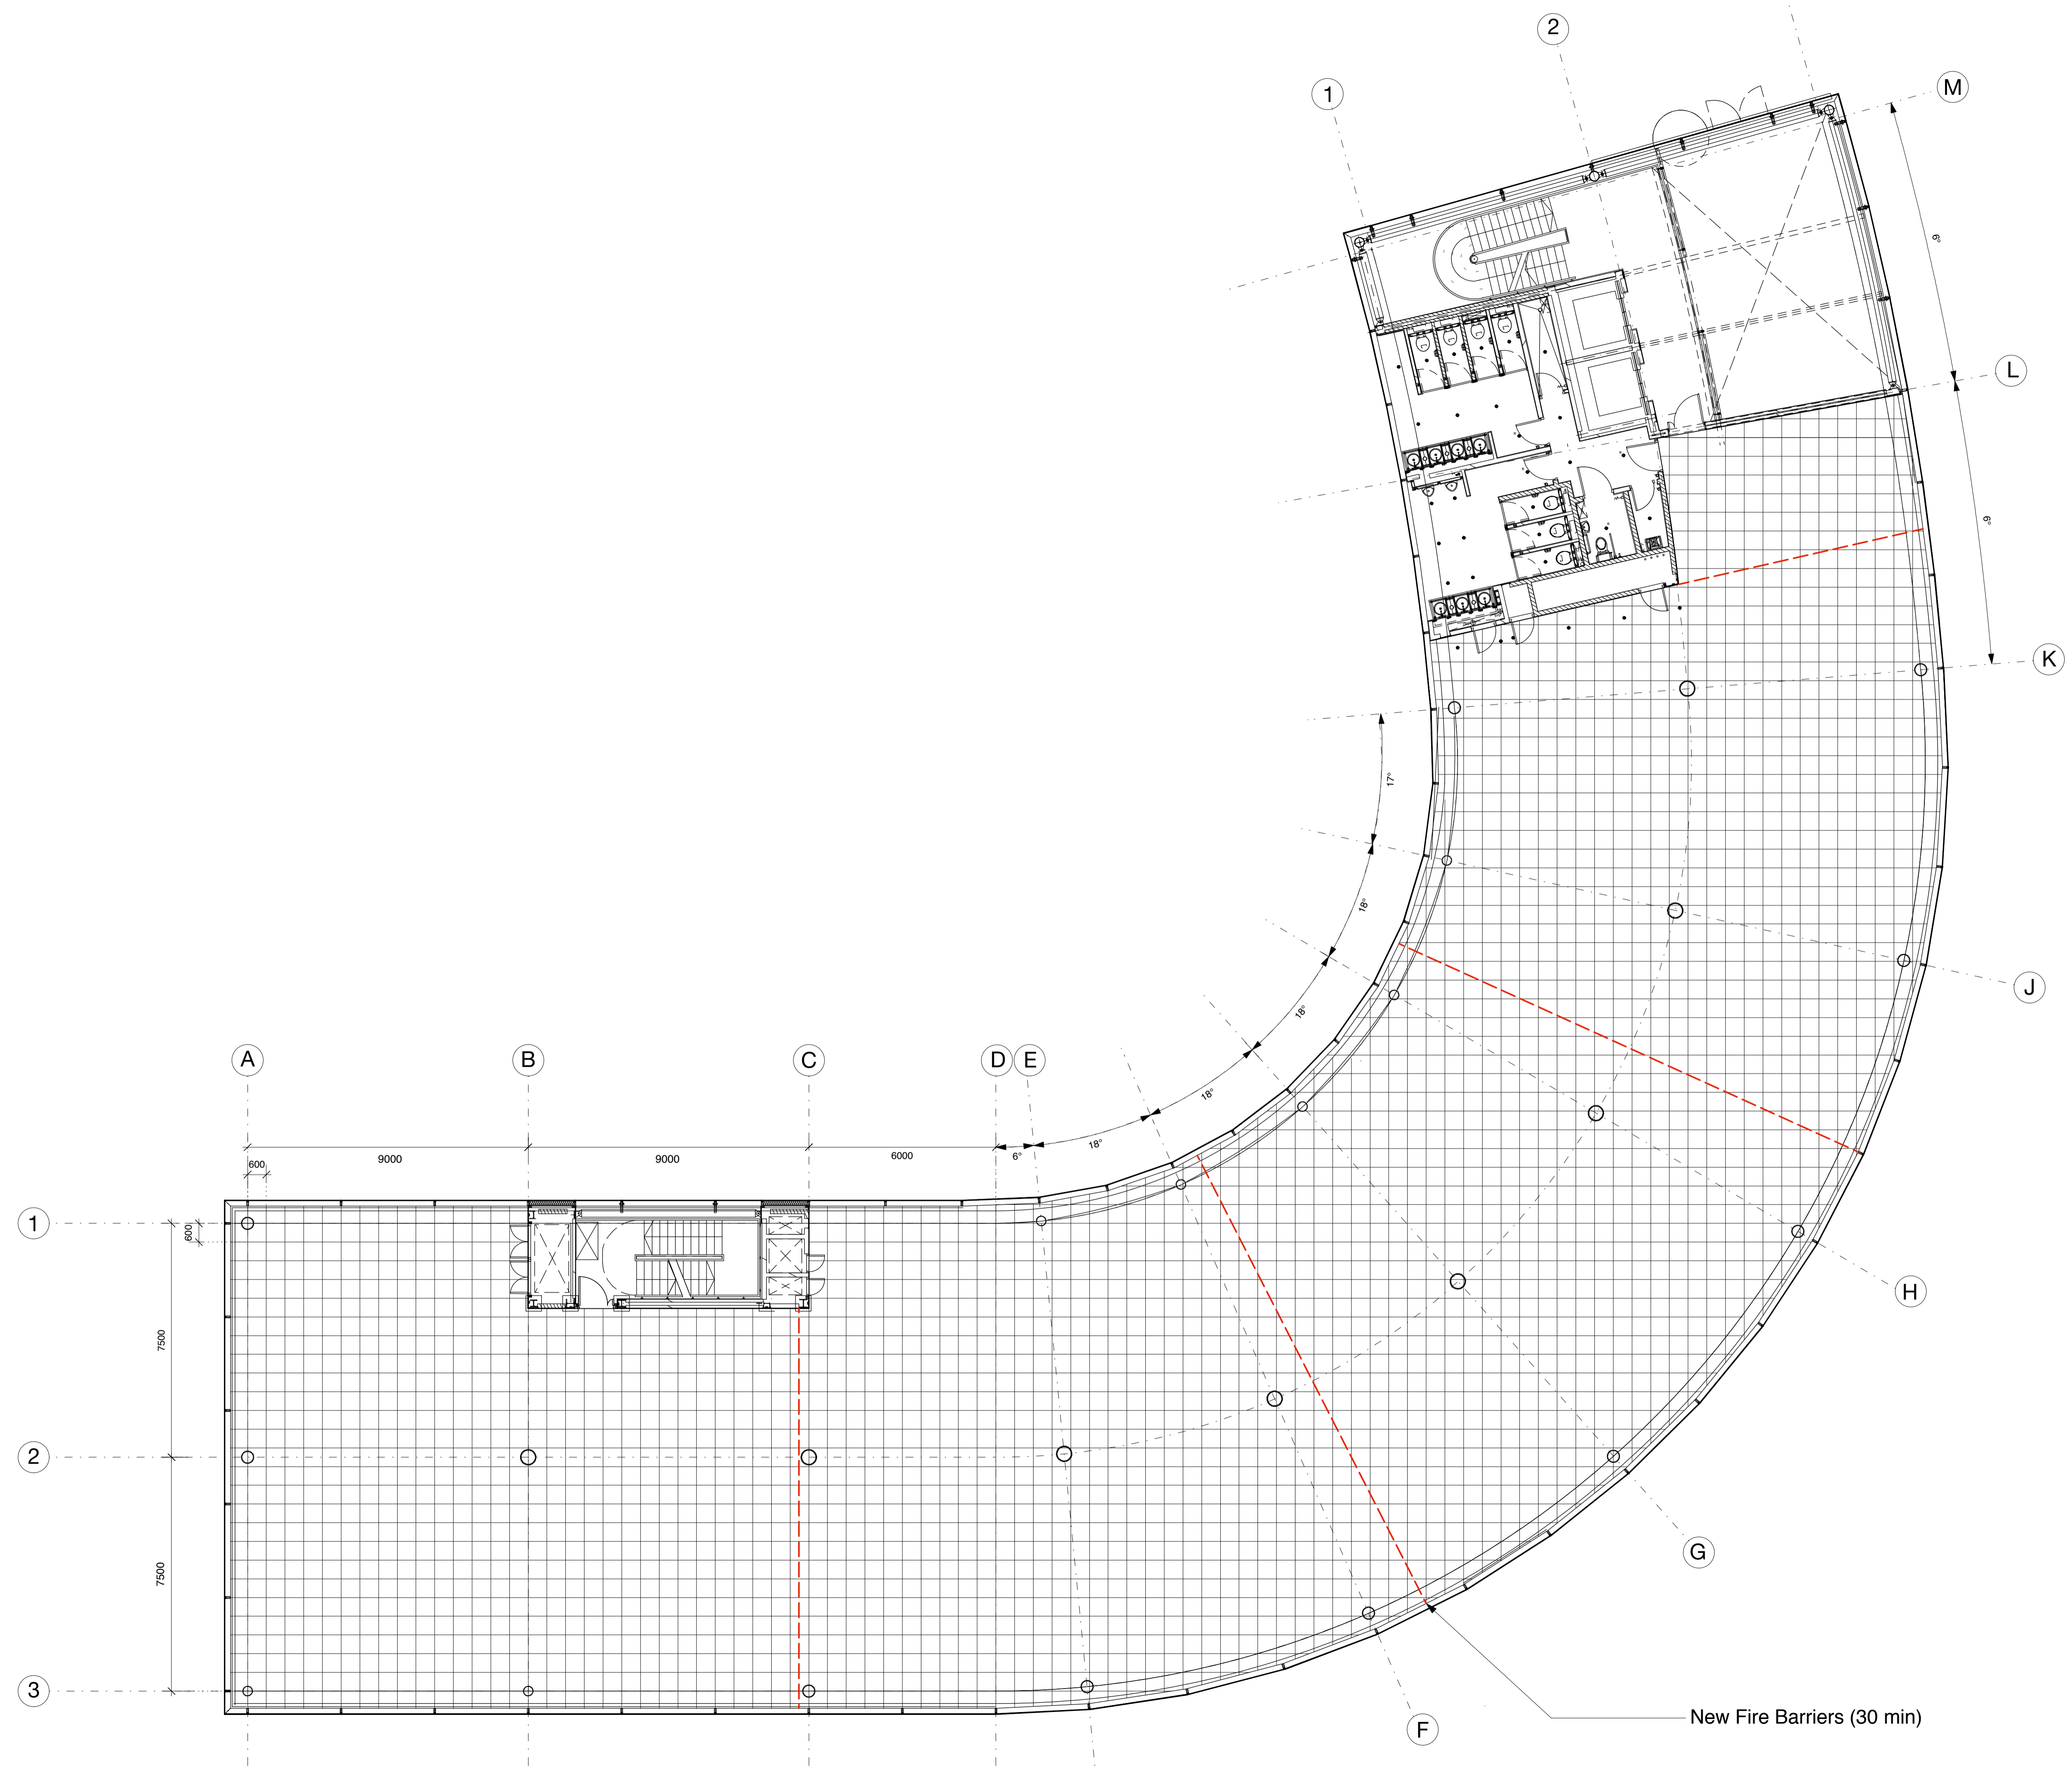


Notes: 1. Do not Scale
 2. Check all dimensions on site
 3. © Pace Jefford Moore Architects llp

KEY

 600 x 600 mm Titan RMG on Titan RMF corner lock pedestals, centered from grid line A2

Note: New Fire Barriers (30 min) to be positioned in locations indicated on the drawing



Record Drawing

No Date By Revision

Project
Building 2, Aviator Park, Addlestone, KT15 2PG

Drawing
 Raised Access Floor Plan, Second Floor

Job Dwg No. Date Drawn
 1386 312 10.02.16

Scale 1:100@A1 Drawing Print Format **A1**

By Checked
 SB GP



PACE | JEFFORD | MOORE ARCHITECTS LLP

16 Hampden Gurney Street, London W1H 5AL
 T 020 7724 7343 E info@pjma.eu W pjma.eu

